

NOT FOR CONSTRUCTION

710 WEST LIONSHEAD CIRCLE
 VAIL SPA CONDOMINIUMS UNIT A
 VAIL COLORADO 81657

k . h . w e b b
 a r c h i t e c t s . p c

AS-BUILT


375 MILL CREEK CIR

No.	Description	Date

Project number 000000
 Date 09-29-19
 Drawn by Author

LOWER FLOOR PLAN

A100

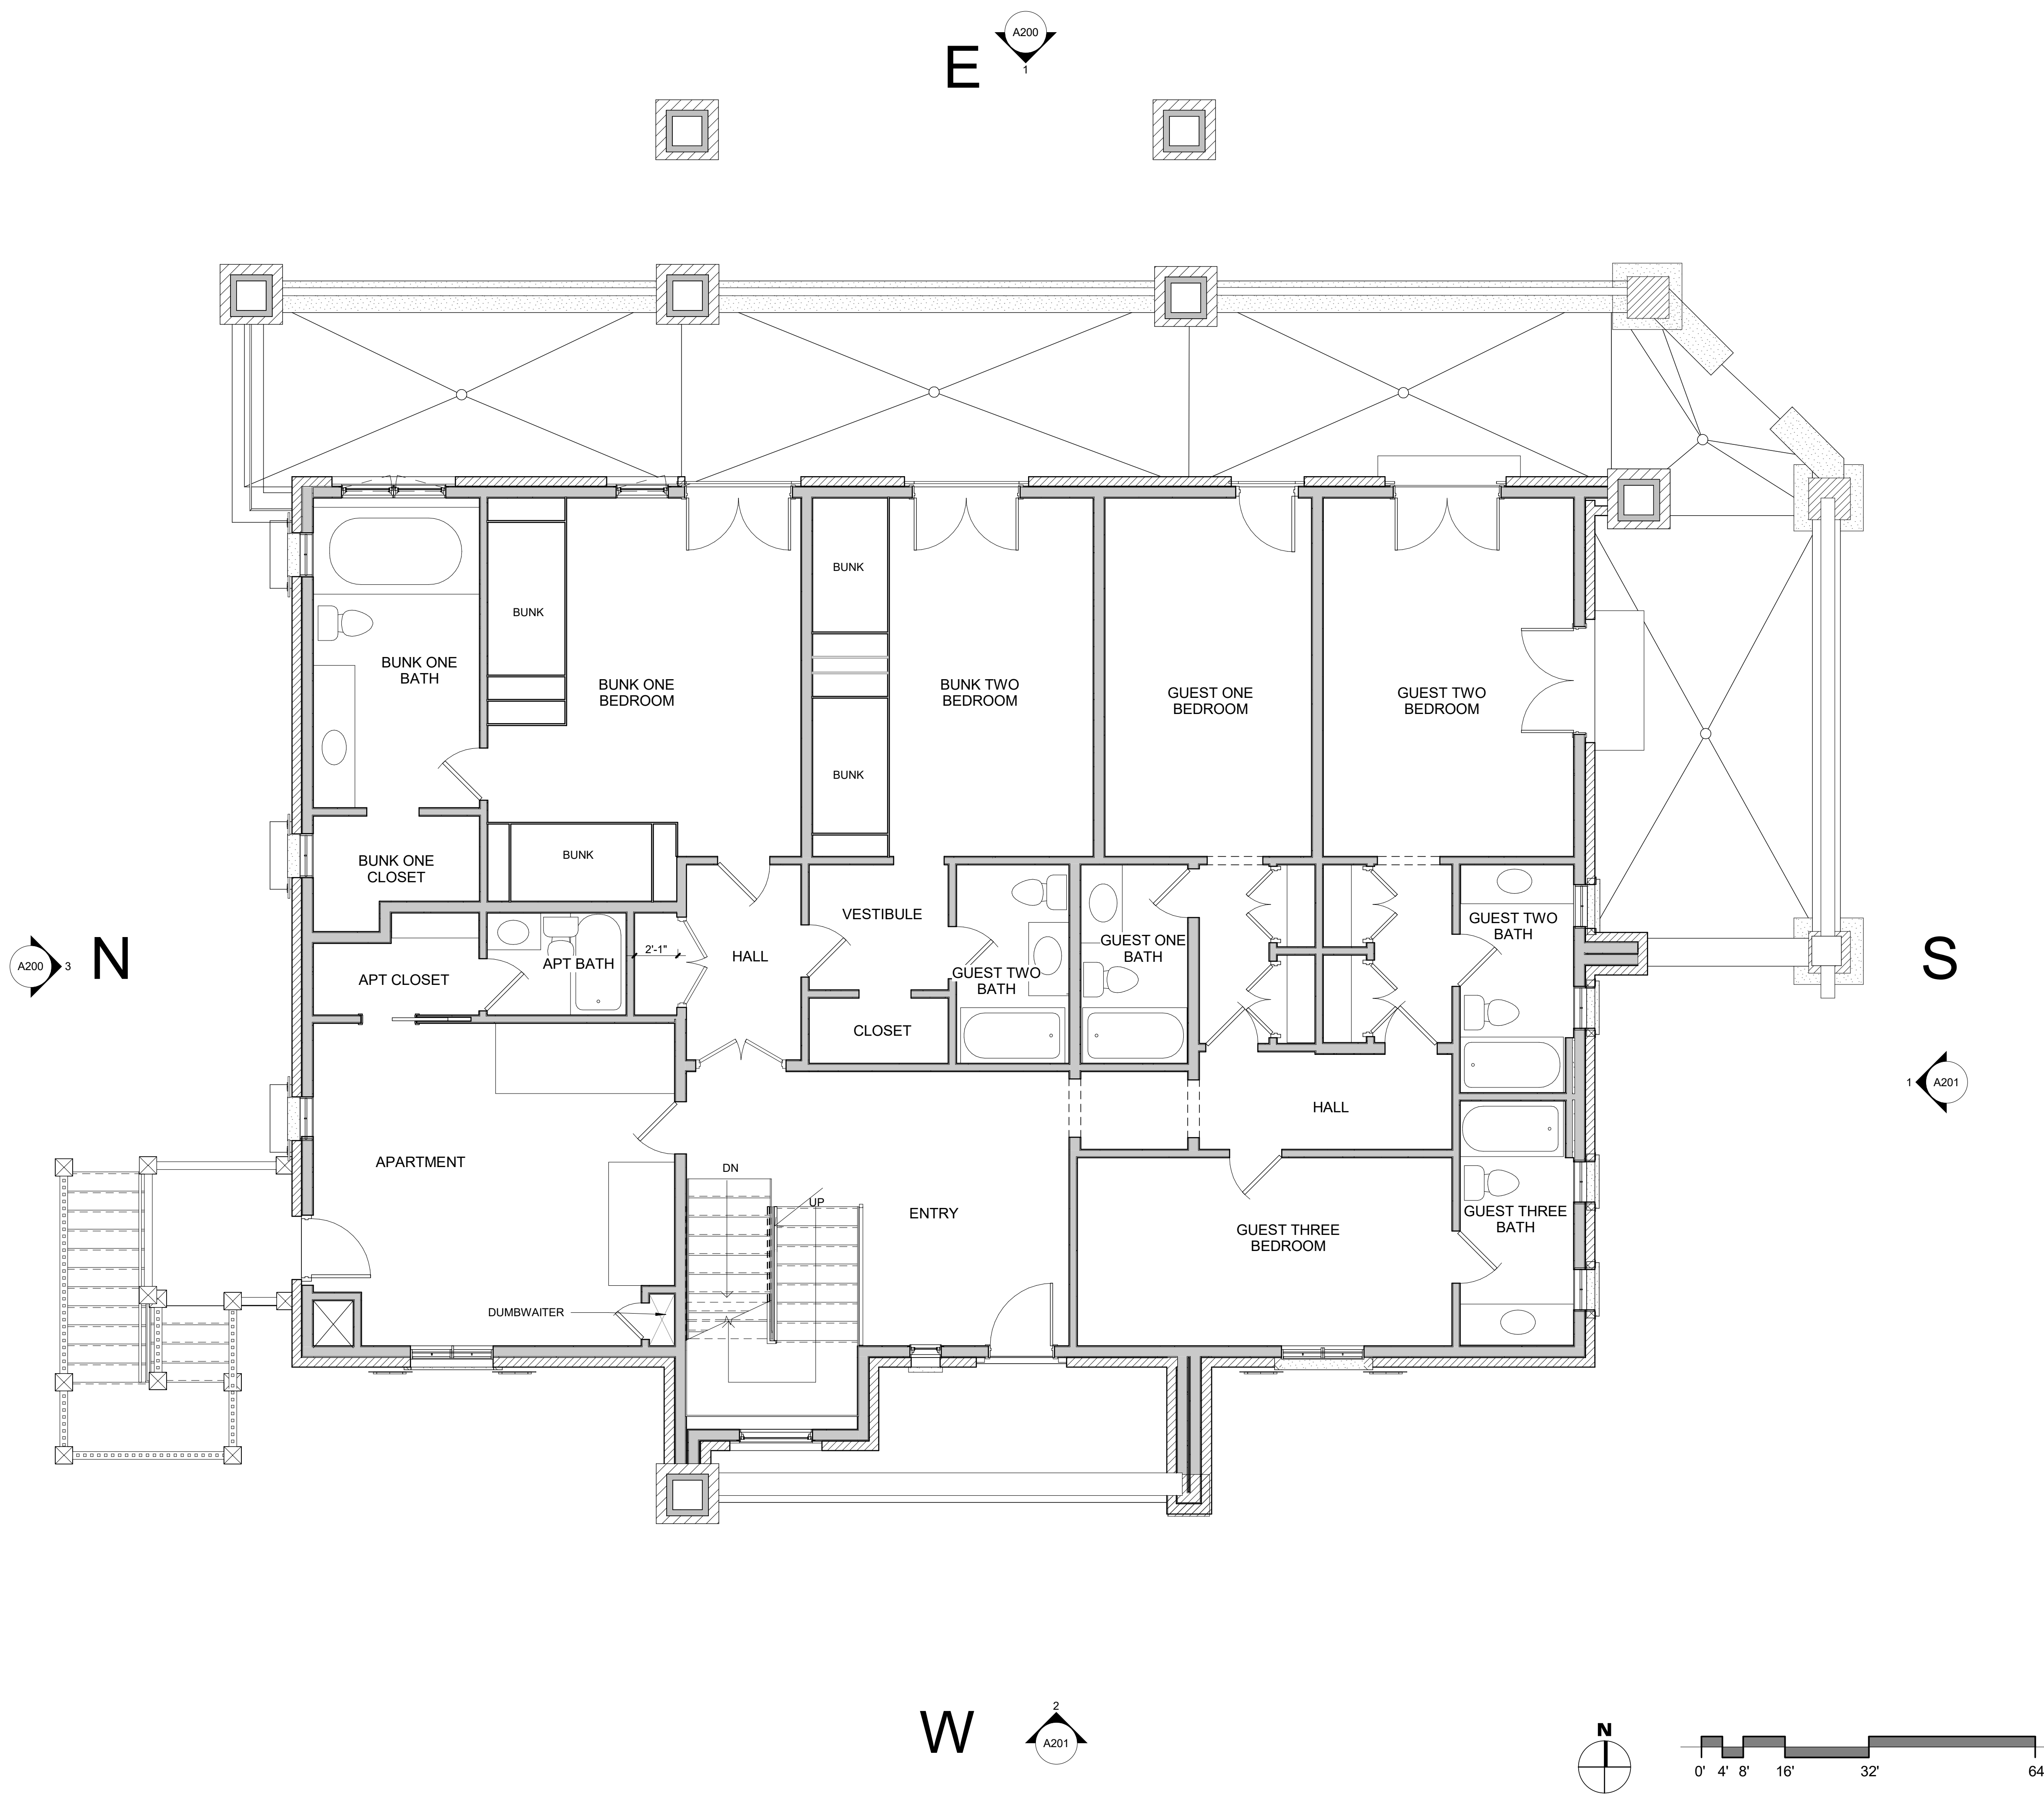

NOT FOR CONSTRUCTION

710 WEST LIONSHED CIRCLE
 VAIL SPA CONDOMINIUMS UNIT A
 VAIL COLORADO 81657

k . h . w e b b
 a r c h i t e c t s . p c

AS-BUILT

375 MILL CREEK CIR

No.	Description	Date






Project number 000000
 Date 09-29-19
 Drawn by Author

ENTRY FLOOR PLAN

A102

9/29/2019 5:53:32 PM

E

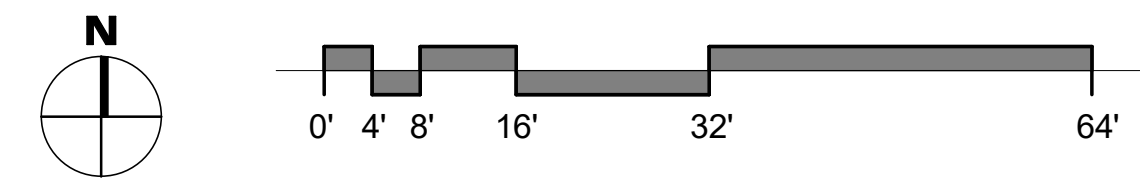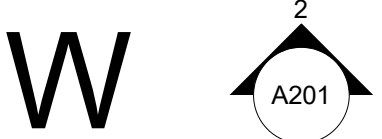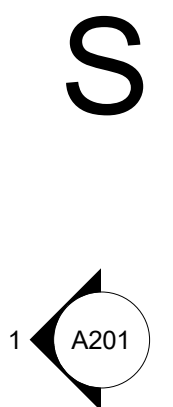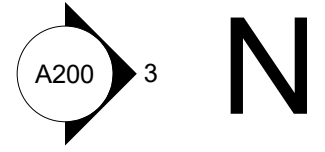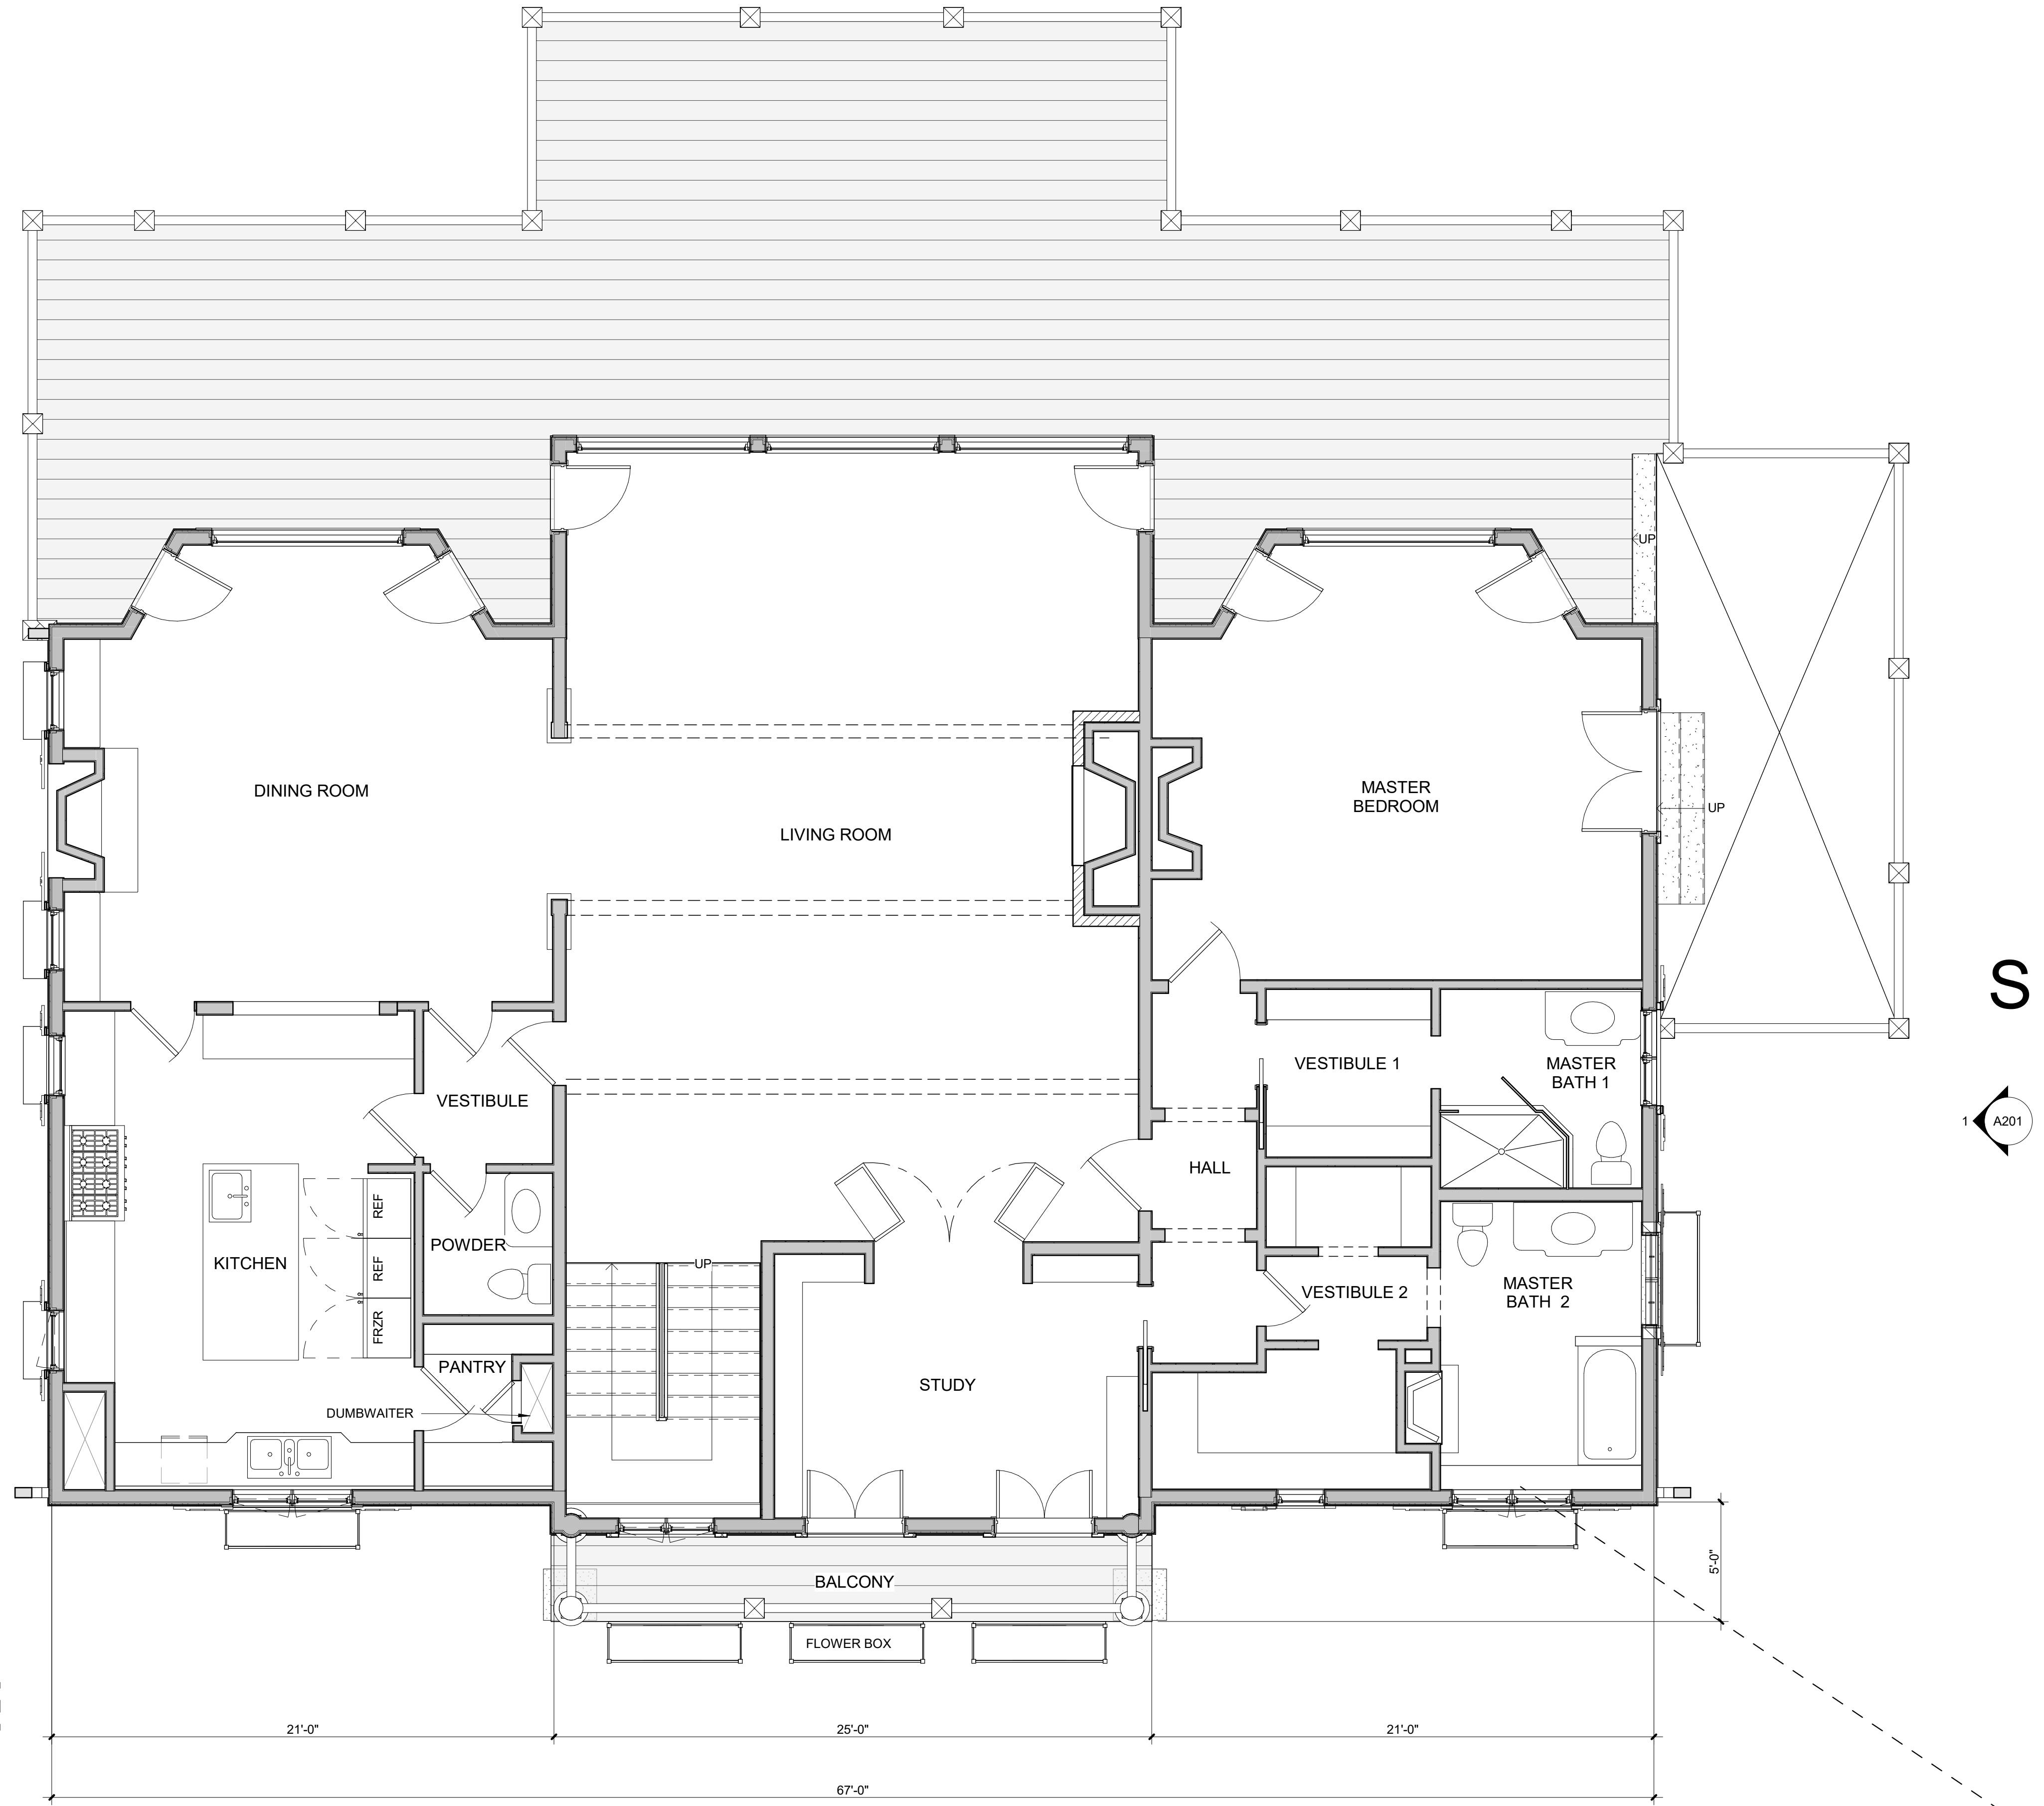

NOT FOR CONSTRUCTION

710 WEST LONSHREAD CIRCLE
 VAIL SPA CONDOMINIUMS, UNIT A
 VAIL COLORADO 81657

k . h . w e b b
 a r c h i t e c t s . p c

AS-BUILT

375 MILL CREEK CIR

No.	Description	Date

Project number 000000
 Date 09-29-19
 Drawn by Author

UPPER FLOOR PLAN




A103

A200
1

A200
3

A201
1

A201
2

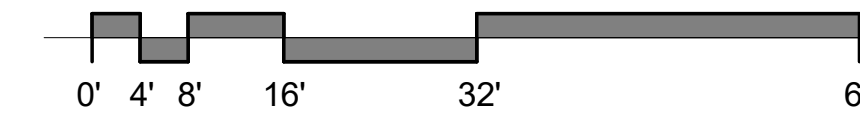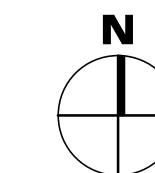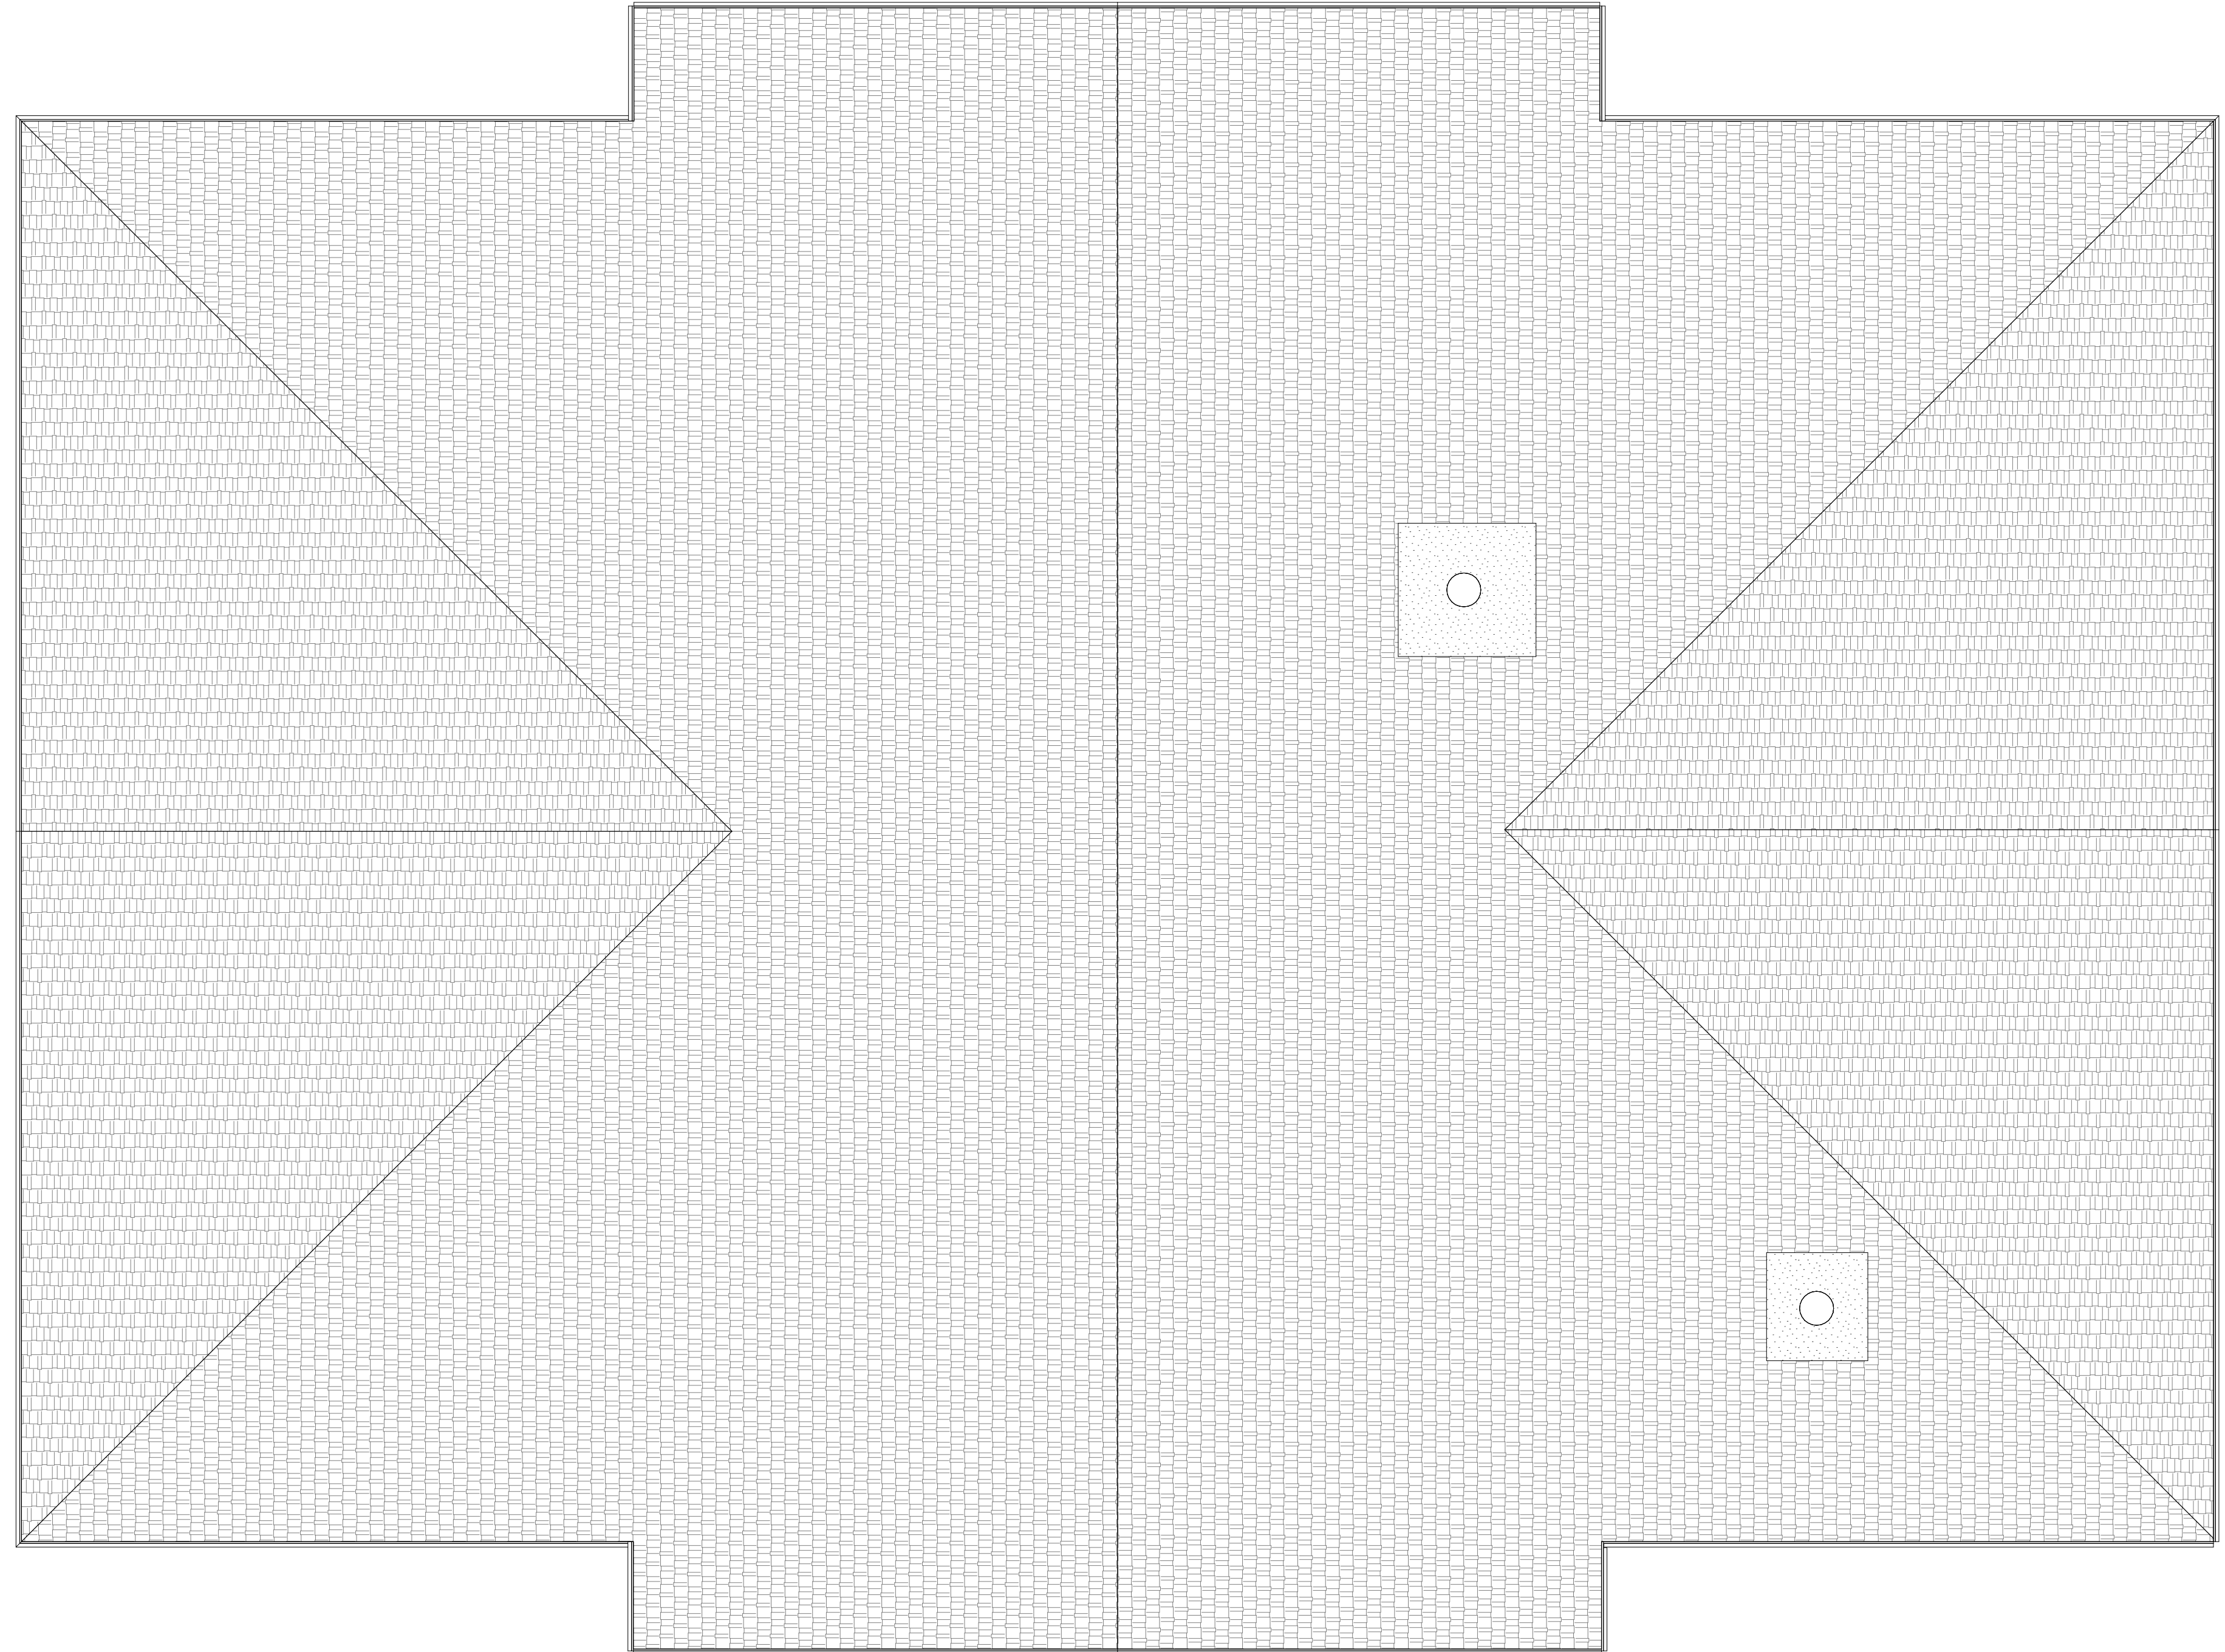

NOT FOR CONSTRUCTION

710 WEST LIONSHEAD CIRCLE
VAIL SPA CONDOMINIUMS UNIT A
VAIL COLORADO 81657

k . h . w e b b
a r c h i t e c t s . p c

AS-BUILT

375 MILL CREEK CIR

No.	Description	Date

Project number 000000
Date 09-29-19
Drawn by Author

ROOF PLAN

A104



NOT FOR CONSTRUCTION

710 WEST LIONHEAD CIRCLE
VAIL SPA CONDOMINIUMS UNIT A
VAIL COLORADO 81657

k . h . w e b b
a r c h i t e c t s . p c

AS-BUILT
375 MILL CREEK CIR

No.	Description	Date

Project number 000000
Date 09-29-19
Drawn by Author

EXTERIOR ELEVATIONS

A200





NOT FOR CONSTRUCTION

710 WEST LIONSHEAD CIRCLE
 VAIL SPA CONDOMINIUMS UNIT A
 VAIL COLORADO 81657

k . h . w e b b
 a r c h i t e c t s . p c

AS-BUILT

375 MILL CREEK CIR

No.	Description	Date

Project number 000000
 Date 09-29-19
 Drawn by Author

EXTERIOR ELEVATIONS

A201